

1

2

3

4

5


6

7

8


A

UPPER VIEW

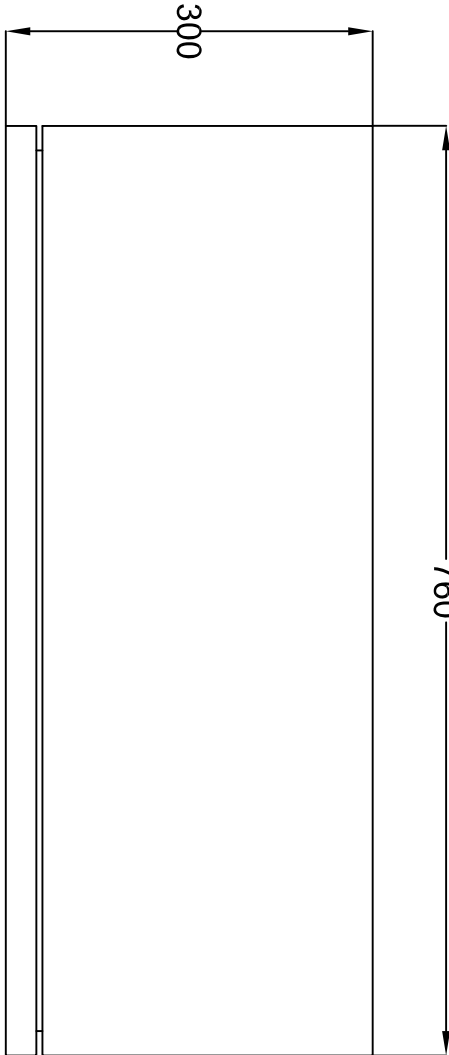


B

LATERAL VIEW

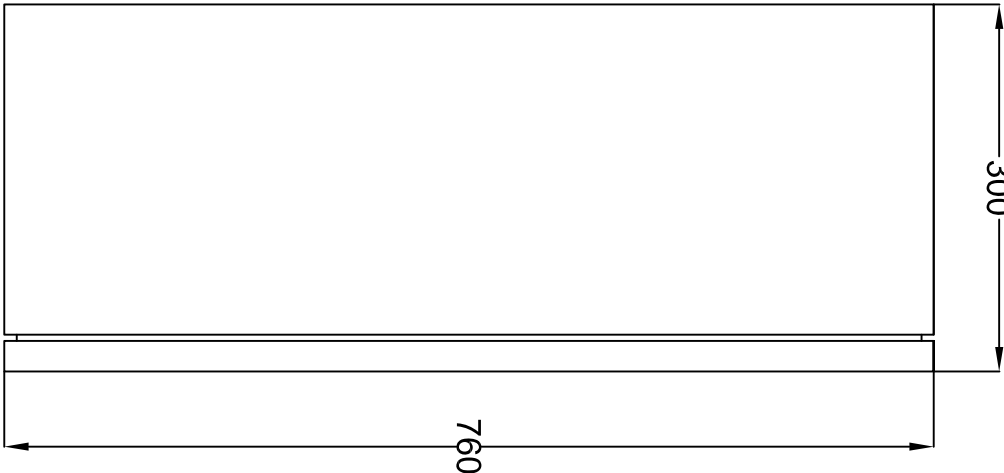

C

FRONT VIEW

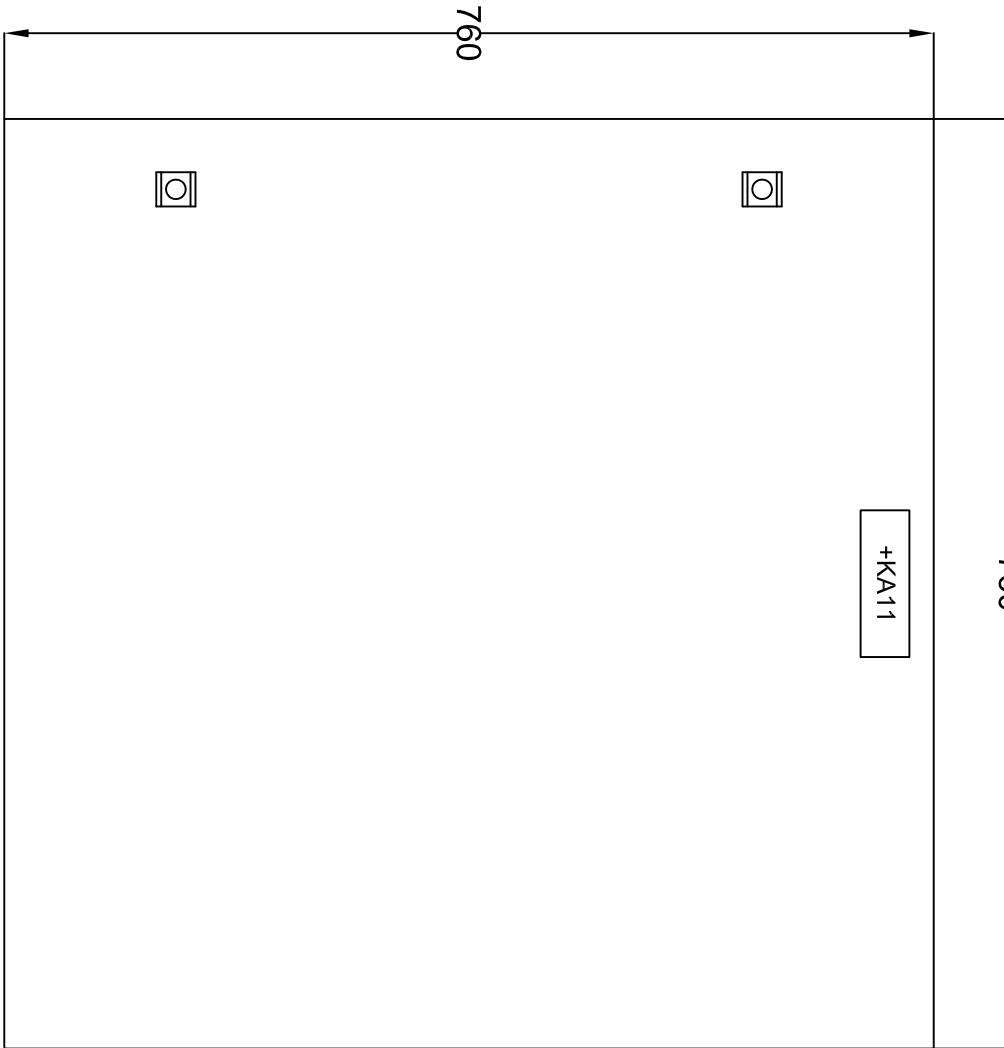

A

B

C

D

Copyng of this document and giving it to others and the use or communication of the contents there of, are forbidden without express authority. Offenders are liable to the payment of damages. All rights are reserved in the event of the grant of patent or the registration of a utility model or design.

Sn nuestra expresa autorizacón queda terminantemente prohibida la reproduccón total o parcial de este documento, así como su uso indebido y / o su exhibición o comunicacón a terceros. De los infractores se exigirá el correspondiente resarcialiente de daños y perjuicios. Se reserva todos los derechos para el caso de la concesión de patente de invención el registro de Modelo Industrial.

Rev.	Notes	Check Date	Done	A.G.H.	SIEMENS MARINE SOLUTIONS Poniente 116 No. 590 Col. Ind. Vallejo México, D. F. Tel: +52 (55) 53282000			SECRETARIA DE MARINA			IMAC		INTEGRATED MONITORING AND CONTROL SYSTEM			Esc. N/A		METRICIA
A	FOR APPROVAL	08-2008	Check	H.C.L.														
B	FOR CONSTRUCTION	09-2008	Aprov	S.B.E.														
C	AS BUILT	04-2010	Date	04-2010														

1

2

3

4

5

6

7

8

PO-163 ARM "INDEPENDENCIA"

+KA11
COMPACT ENCLOSURE
STAINLESS STEEL
VIEWS

Drawing No:
E10482-UA033-V203

Sheet: 1
Of: 2

																																																																																																																																																																																																																																																																																																																																																																																																																																																																																																																																																																																																																																																																																																																																																																																																																																																																																																																																																																																																																																																																																																																																																																																																																																																																																																		</	
--	--	----	--