

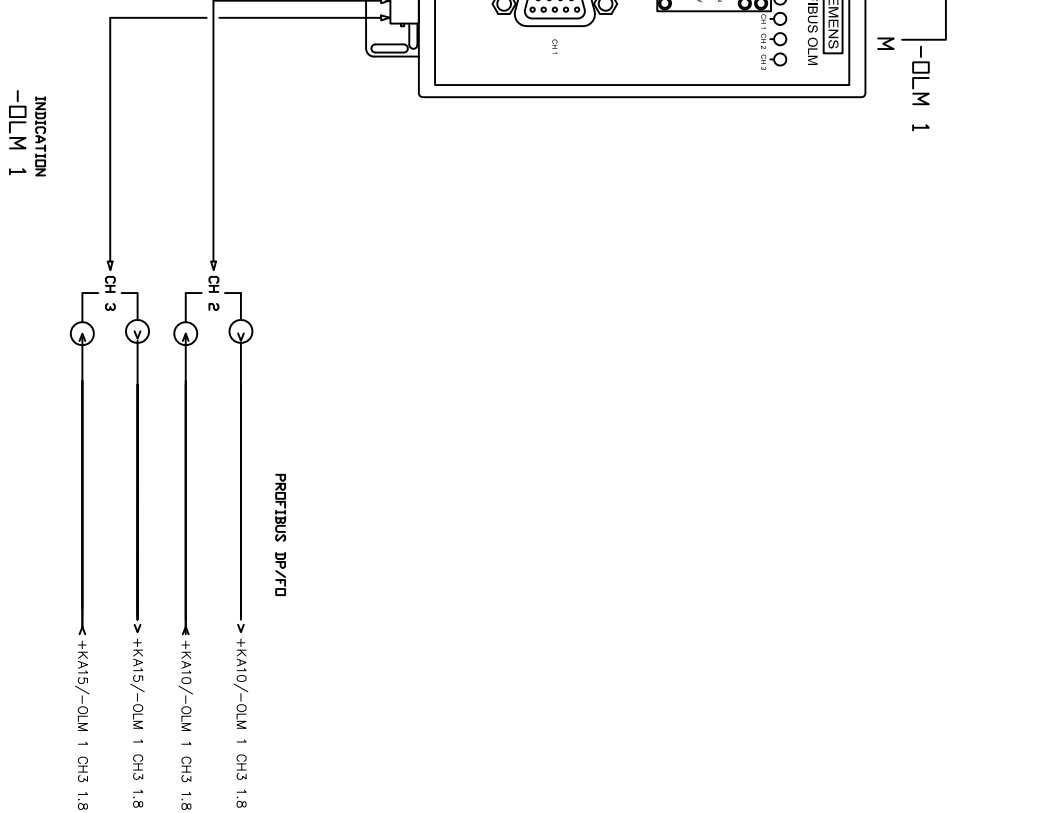


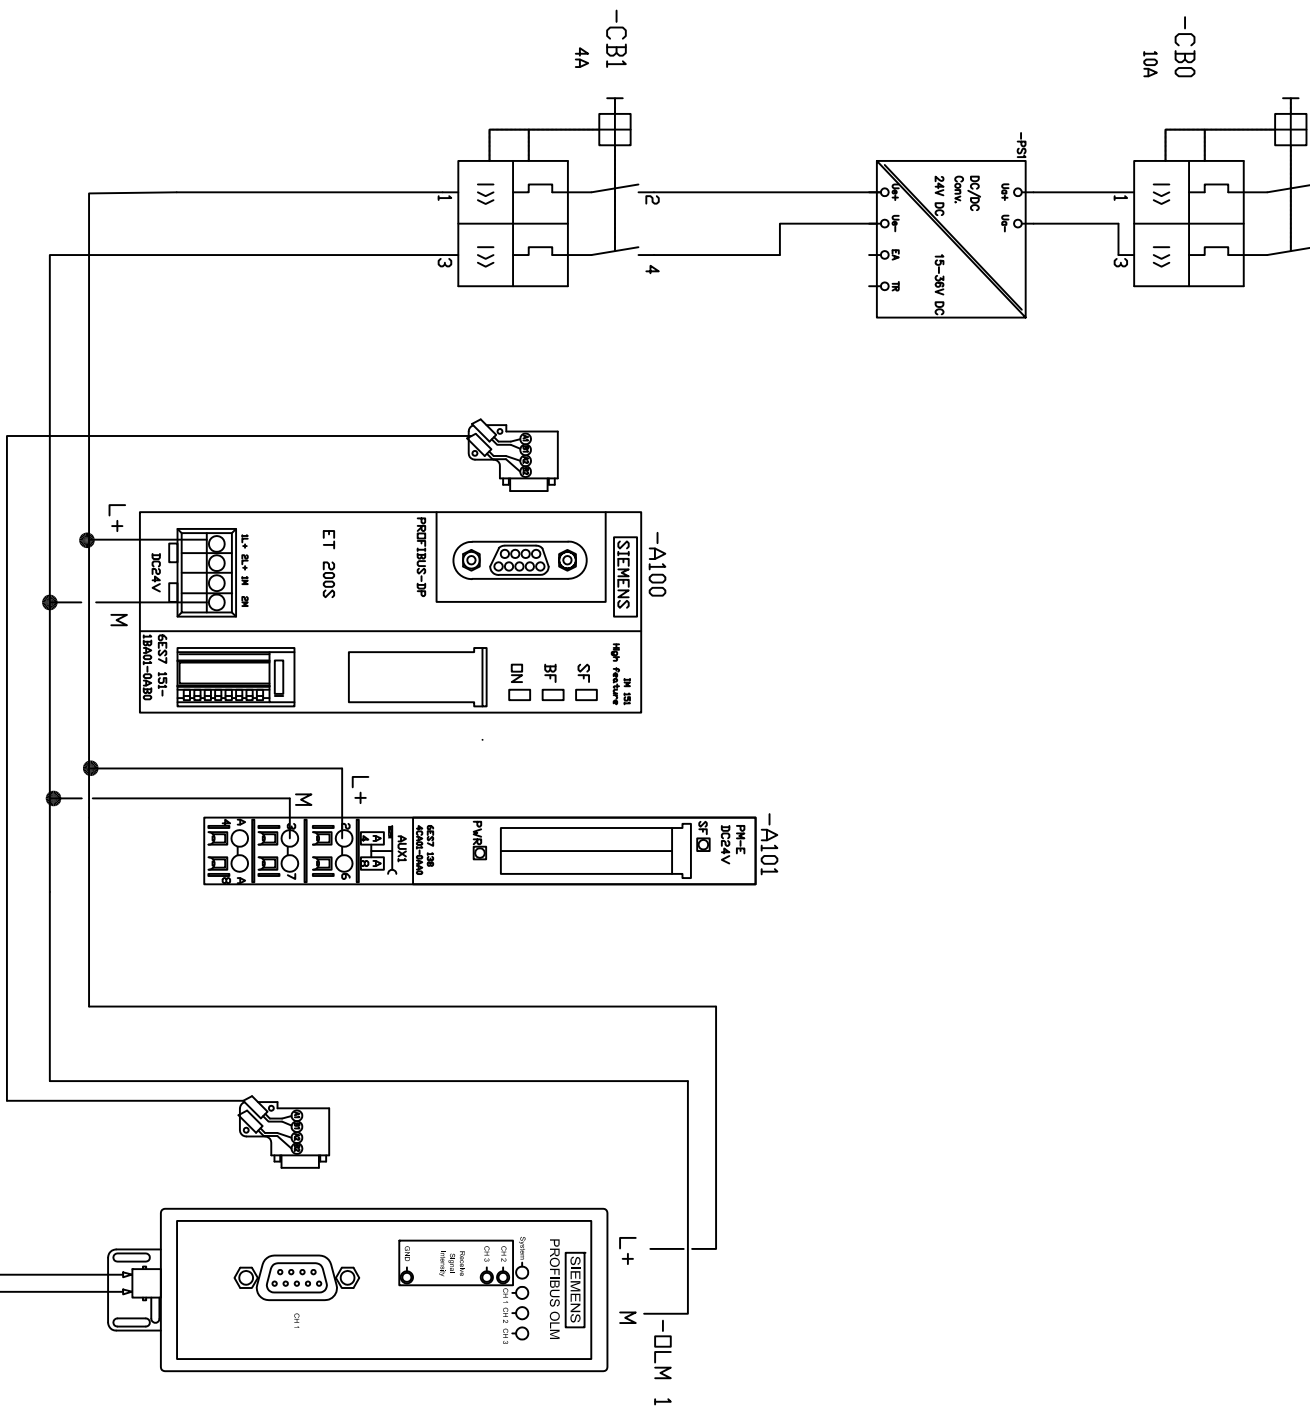

Copying of this document and giving it to others and the use or communication of the contents there of, are forbidden without express authority. Offenders are liable to the payment of damages. All rights are reserved in the event of the grant of patent or the registration of a utility model or design.

Sin nuestra expresa autorización queda terminantemente prohibida la reproducción total o parcial de este documento, así como su uso indebido y/o su exhibición o comunicación a terceros. De los infractores se exigirá el correspondiente resarcimiento de daños y perjuicios. Se reserva todos los derechos para el caso de la concesión de patente de invención el registro de Modelo Industrial.

Rev.	Notes	Check Date	Done	A.G.H.	SIEMENS MARINE SOLUTIONS SECRETARIA DE MARINA PO-163 ARM "INDEPENDENCIA" IMAC +KA14 CIRCUIT DIAGRAM	INTEGRATED MONITORING AND CONTROL SYSTEM		Esc.	N/A	METRICS
A	FOR APPROVAL	08-2008	Check	H.C.L.		Acot. mm				
B	FOR CONSTRUCTION	09-2008	Aprov	S.B.E.		Drawing No:		Sheet: 1		
C	AS BUILT	04-2010	Date	04-2010		E10482-U4033-S206		Of: 4		

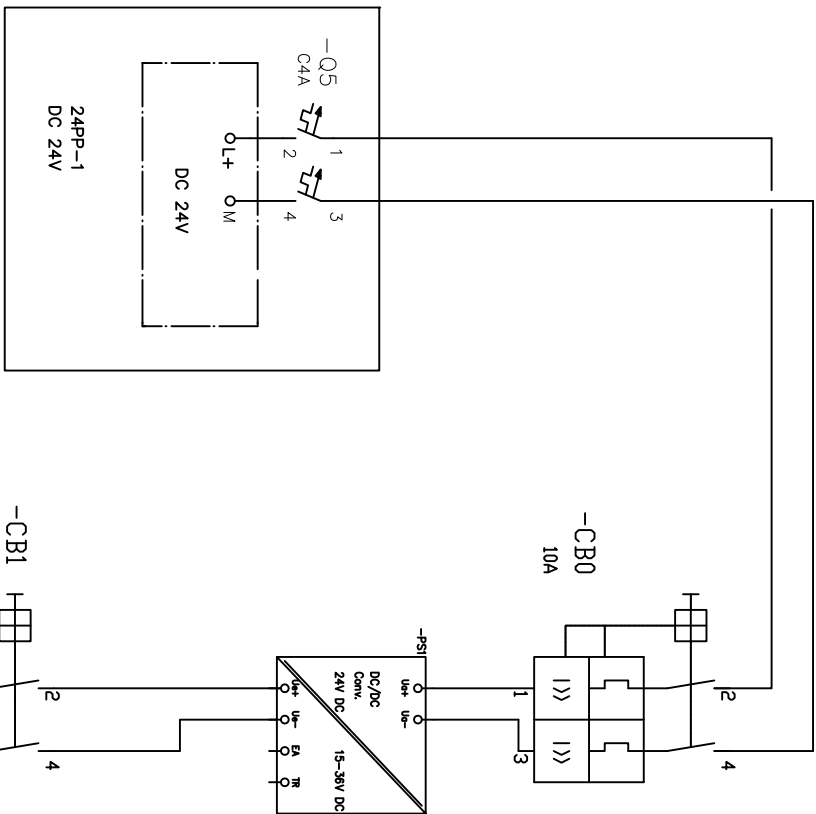